



**Central New York's Water Authority**  
[www.ocwa.org](http://www.ocwa.org)

200 NORTHERN CONCOURSE  
P.O. BOX 4949  
SYRACUSE, NY 13221-4949

PHONE: (315) 455-7061  
FAX: (315) 455-8510

March 3, 2025

Mr. Kevin Rode, Supervisor  
Town of Lysander  
8220 Loop Road  
Baldwinsville, NY 13027

Re: OCWA Project No. 9004151  
Install 3 Hydrants - Whitetail Woods Section D  
Town of Lysander

Dear Mr. Rode:

This is to inform you that OCWA has installed the following hydrants in the Cold Springs WSD O505, Town of Lysander.

Hydrant #15254 – Long Bow Way – 400' South of Buck Trail.  
Hydrant #15255 – Buck Trail – NE Corner of Buck Trail and Longbow Way  
Hydrant #15256 – Buck Trail – 400' West of Longbow Way

These hydrants were installed in compliance with the Application of Request, dated 10/23/2023. A copy of our map file showing the hydrants is enclosed.

Service to these hydrants was effective as of 2/14/2025, and the current maintenance rate for service is \$92.96 per hydrant per annum.


Very truly yours,

OCWA

A handwritten signature in black ink, appearing to read 'PSherlock', is written over the printed name.


Patrick Sherlock, P.E.  
Engineering Manager

LOCATION OF UTILITIES ARE APPROXIMATE AND SHOULD BE VERIFIED BY CONTRACTOR IN FIELD.

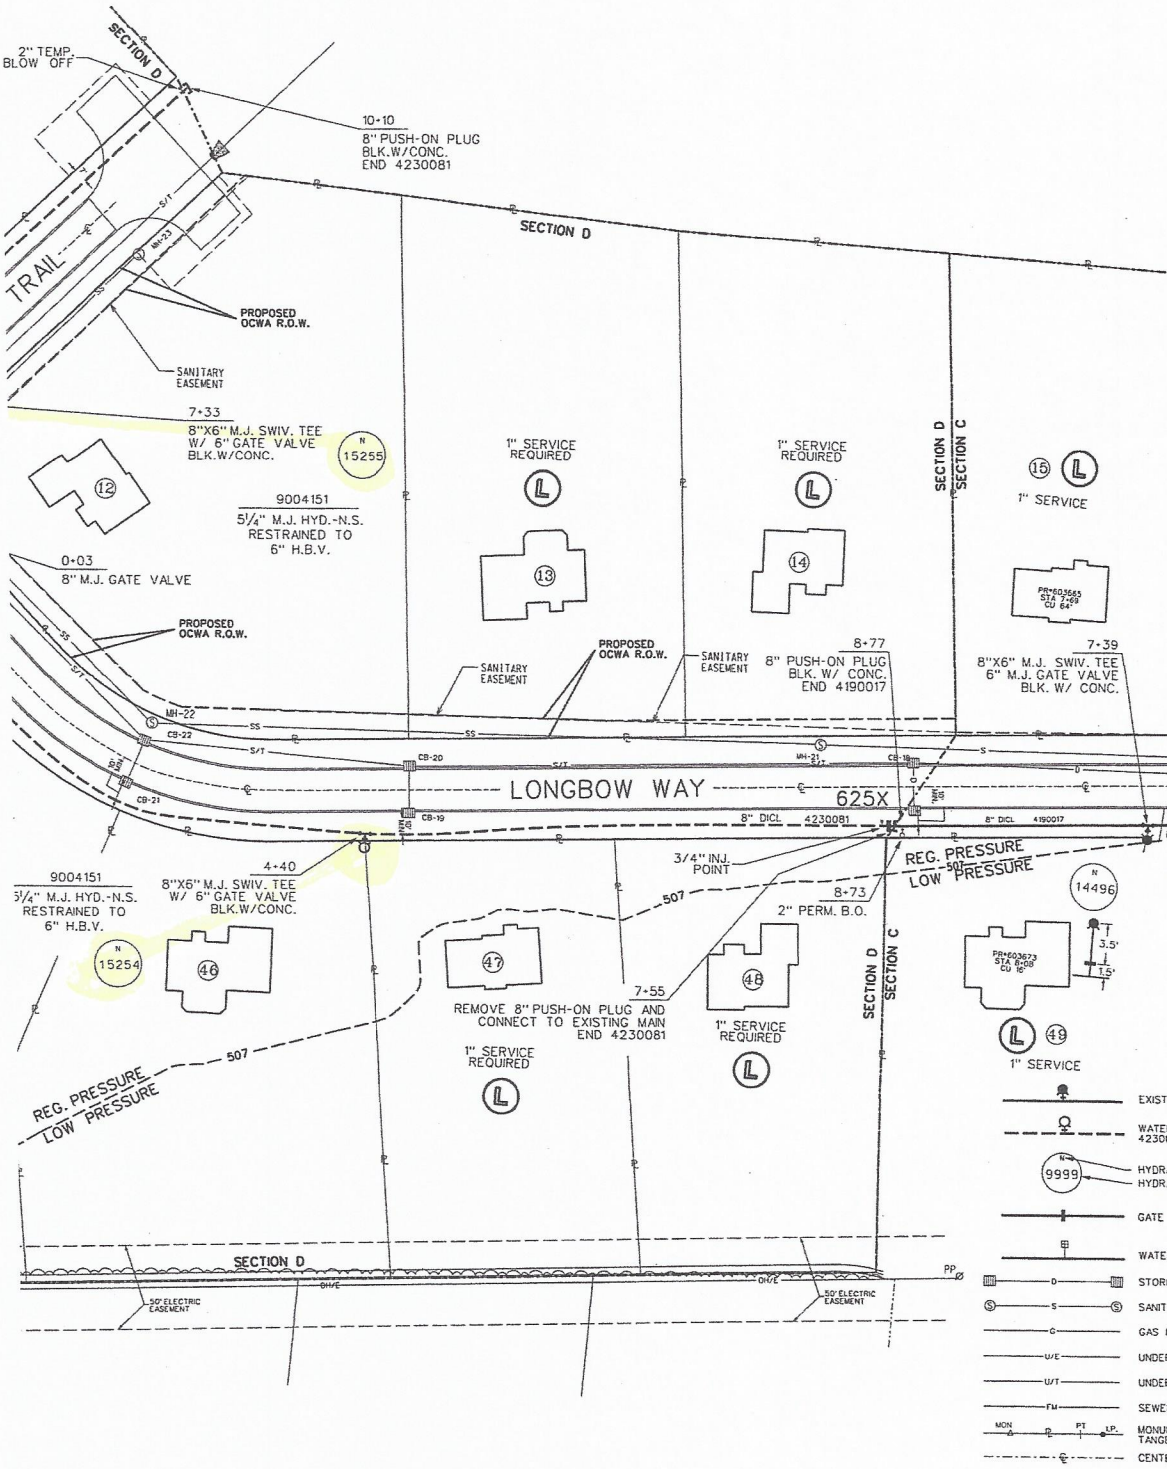

FOR SHUT-DOWN SEE VALVE SKETCH 604A

- LEGEND**
- EXISTING WATER MAINS & HYDRANTS
  - WATER MAINS & HYDRANTS INSTALLED UNDER 4230081, 9004151
  - HYDRANT THREAD CODE  
HYDRANT NUMBER
  - GATE VALVE
  - WATER SERVICE & CURB BOX
  - STORM SEWER W/ CATCH BASINS
  - SANITARY SEWER W/ MANHOLES
  - GAS MAIN
  - UNDERGROUND ELECTRIC CABLE
  - UNDERGROUND TELEPHONE CABLE
  - SEWER FORCE MAIN
  - MONUMENT, PROPERTY LINE, POINT OF TANGENT & IRON PIPE
  - CENTERLINE OF ROAD

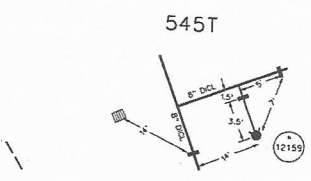

CONTRACTOR TO MAINTAIN 18\"/>

- LOW PRESSURE

**PRESSURE CHECK**

SUPPLY TDH (HIGHEST) - 610'	SUPPLY TDH (LOWEST) - 610'
GROUND ELEV. (LOWEST) - 470'	GROUND ELEV. (HIGHEST) - 510'
FEET OF HEAD - 140' X .43	FEET OF HEAD - 100' X .43
HIGHEST PRESSURE - 60 PSI	LOWEST PRESSURE - 4.3 PSI

**ALL POLYWRAPPED  
DESIGN DRAWING**  
THIS DRAWING IS INTENDED FOR CONSTRUCTION.  
SEE RECORD DRAWING WHEN COMPLETE.  
FOR AS BUILT INFORMATION.

SHEET 6E

0505 - COLD SPRINGS WSD '400' Pg. 41-15

4N SEE 545U



*Patrick M. Sherlock*  
PATRICK M. SHERLOCK N.Y.S. P.E. LIC. NO. 091836



10/19/23  
DATE

REVISION	DATE BY
PLAN APPROVED	10/13/23 PMS

<b>OCWA</b>	
NORTHERN CONCOURSE	PO BOX 4949 SYRACUSE, NY 13211
8" MAIN EXTENSION <b>WHITETAIL WOODS</b> SECTION D TOWN OF LYSANDER	
DESIGN JAK	SCALE: 1" = 50'
DRAWN JAK	MAP FILE 30
CHECKED SJD	TRACT MAP
DATE 10/13/23	FILE No. 4230081 9004151

DOCUMENT IS EXCEPTING AS PART 2 OF LOCATION LAW.

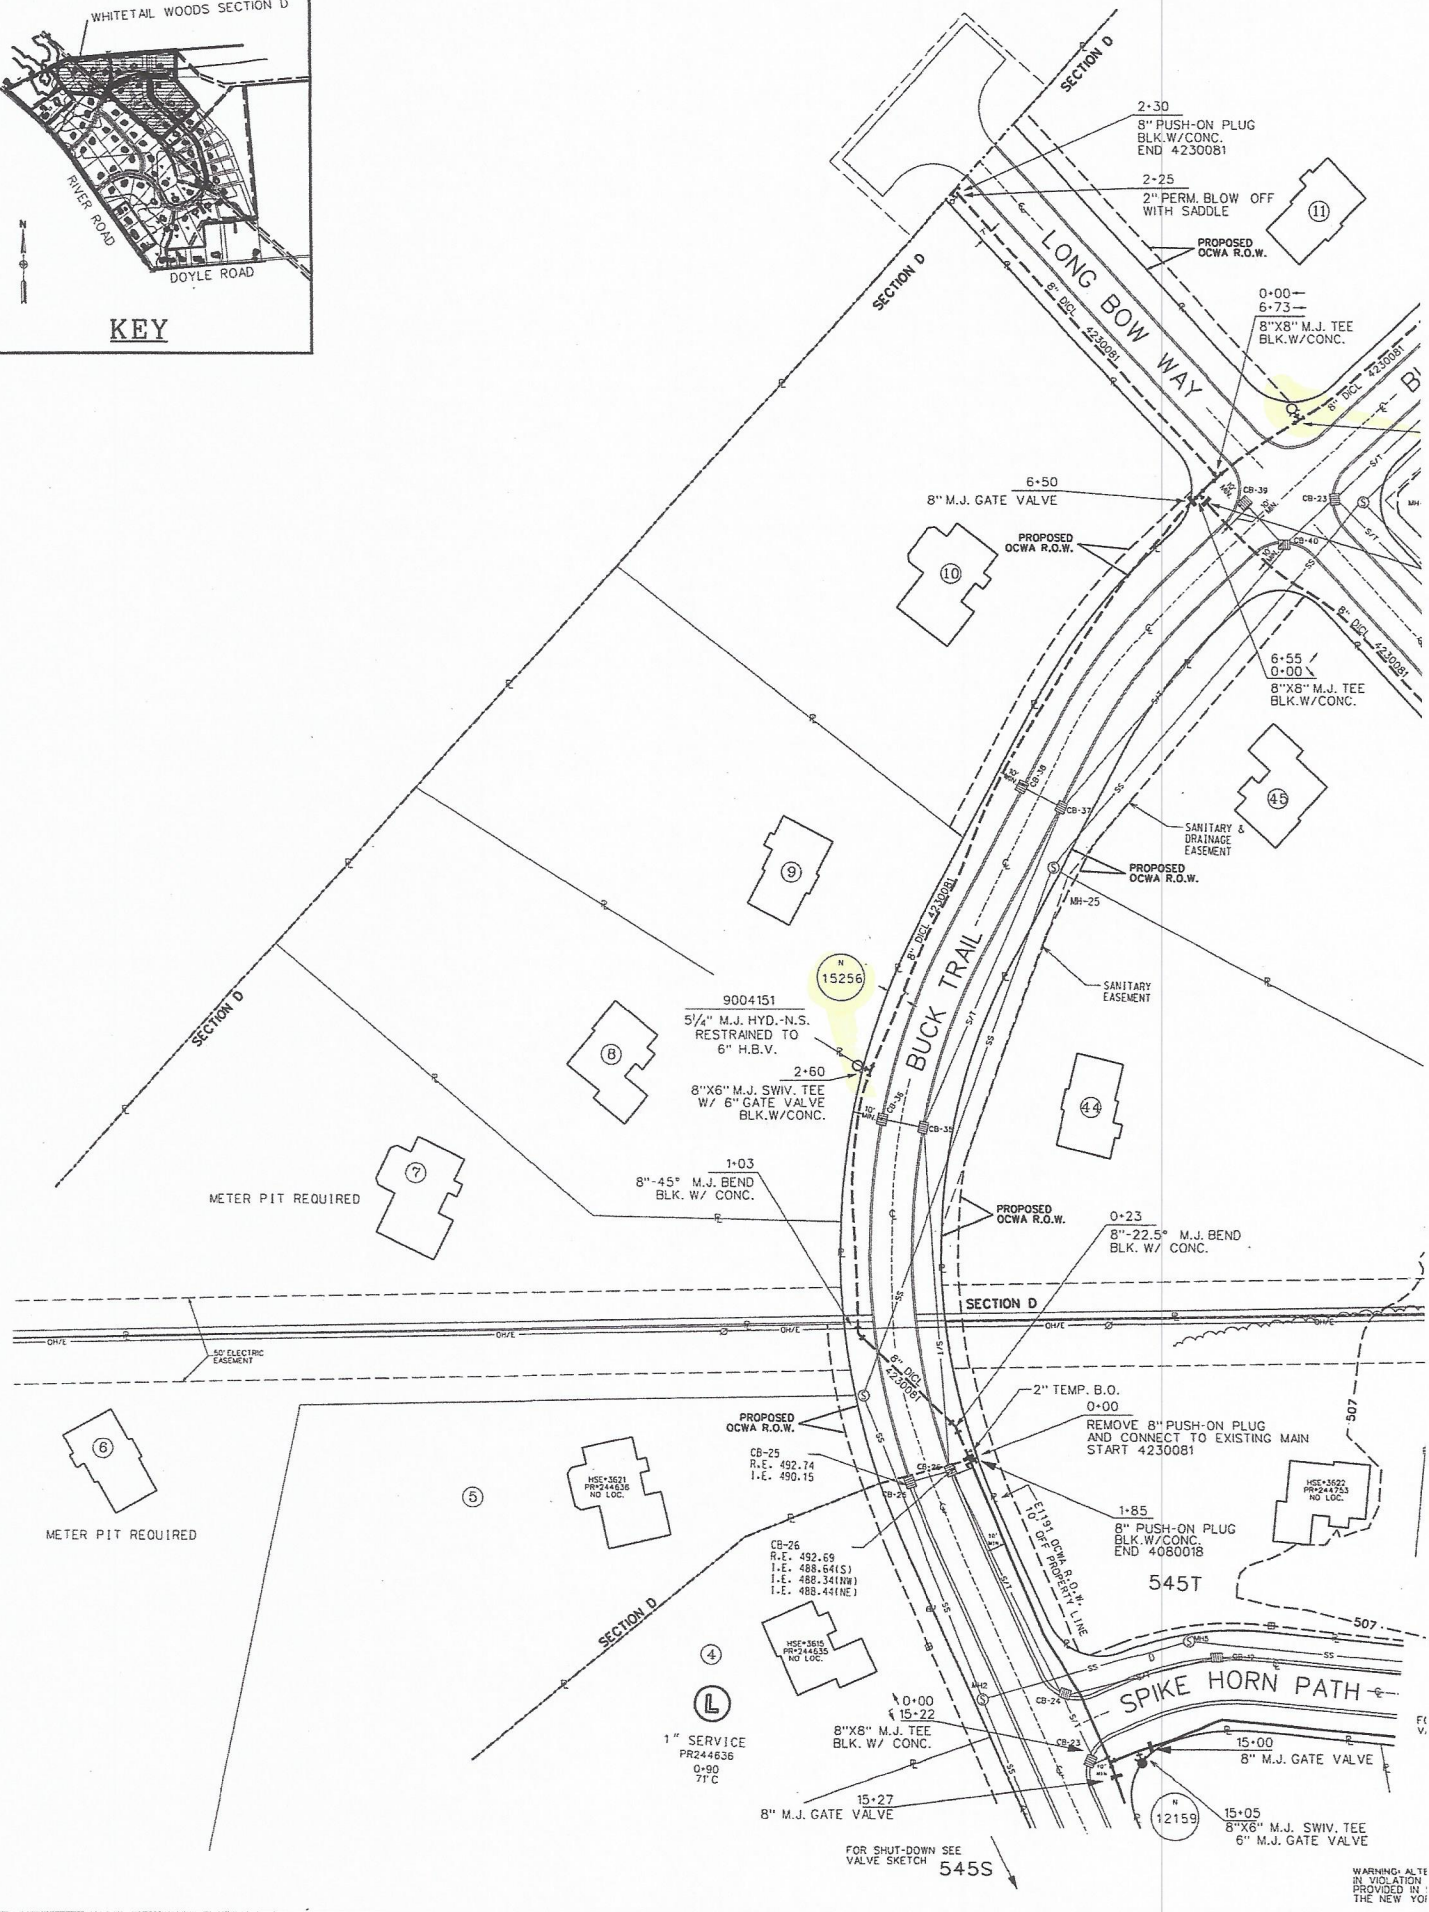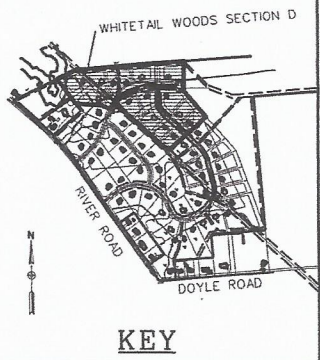

WARNING: ALTE  
BL. INDICATION  
PROVIDED IN  
THE NEW YO